

MIAMI-DADE COUNTY, FLORIDA METRO-DADE FLAGLER BUILDING 140 WEST FLAGLER STREET, SUITE 1603 MIAMI, FLORIDA 33130-1563 (305) 375-2901 FAX (305) 375-2908

www.miamidade.gov/buildingcode

## **NOTICE OF ACCEPTANCE (NOA)**

YKK AP America 7680 The Bluffs, Suite 100 Austell, GA 30168

#### Scope:

This NOA is being issued under the applicable rules and regulations governing the use of construction materials. The documentation submitted has been reviewed by Miami-Dade County Product Control Division and accepted by the Board of Rules and Appeals (BORA) to be used in Miami Dade County and other areas where allowed by the Authority Having Jurisdiction (AHJ).

This NOA shall not be valid after the expiration date stated below. The Miami-Dade County Product Control Division (In Miami Dade County) and/or the AHJ (in areas other than Miami Dade County) reserve the right to have this product or material tested for quality assurance purposes. If this product or material fails to perform in the accepted manner, the manufacturer will incur the expense of such testing and the AHJ may immediately revoke, modify, or suspend the use of such product or material within their jurisdiction. BORA reserves the right to revoke this acceptance, if it is determined by Miami-Dade County Product Control Division that this product or material fails to meet the requirements of the applicable building code.

This product is approved as described herein, and has been designed to comply with the Florida Building Code, including High Velocity Hurricane Zone of the Florida Building Code.

**DESCRIPTION:** Series "35H" Aluminum Outswing Entrance Door -LMI

**APPROVAL DOCUMENT:** Drawing No. **W03-94**, titled "Series "35H" Aluminum Outswing Entrance Door - L.M.I.", sheets 1 through 11 of 11, prepared by AL-Farooq Corporation, dated 10/20/03 and last revised on MAR 29, 2004, signed and sealed by Dr. Humayoun Farooq, P.E., bearing the Miami-Dade County Product Control renewal stamp with the Notice of Acceptance number and expiration date by the Miami-Dade County Product Control Division.

# MISSILE IMPACT RATING: Large Missile Impact Resistant

#### Limitation:

- 1. Maximum Design Pressure Rating: The design pressures load capacity tables (psf) on sheets 2 and 3 shall be Divided by 1.33 to obtain the Allowable Design Pressure.
- 2. Glass types 1 and 2 are not Valid 3. Optional Threshold Ramp to be properly secured & reviewed by AHJ

**LABELING:** Each unit shall bear a permanent label with the manufacturer's name or logo, city, state and following statement: "Miami-Dade County Product Control Approved", unless otherwise noted herein.

**RENEWAL** of this NOA shall be considered after a renewal application has been filed and there has been no change in the applicable building code negatively affecting the performance of this product.

**TERMINATION** of this NOA will occur after the expiration date or if there has been a revision or change in the materials, use, and/or manufacture of the product or process. Misuse of this NOA as an endorsement of any product, for sales, advertising or any other purposes shall automatically terminate this NOA. Failure to comply with any section of this NOA shall be cause for termination and removal of NOA.

**ADVERTISEMENT:** The NOA number preceded by the words Miami-Dade County, Florida, and followed by the expiration date may be displayed in advertising literature. If any portion of the NOA is displayed, then it shall be done in its entirety.

**INSPECTION:** A copy of this entire NOA shall be provided to the user by the manufacturer or its distributors and shall be available for inspection at the job site at the request of the Building Official.

This NOA revises NOA # 04-0227.02 consists of this page 1 and evidence sheet E-1 as well as approval document mentioned above.

The submitted documentation was reviewed by Ishaq I. Chanda, P.E.



NOA No 09-0518.09 Expiration Date: June 10, 2010 Approval Date: June 10, 2009 Page 1

### **NOTICE OF ACCEPTANCE: EVIDENCE PAGE**

- A. DRAWINGS (transferred from file # 04-0227.02)
- 1. Manufacturer's die drawings and sections.
- 2. Drawing No. W03-94, titled "Series "35H" Aluminum Outswing Entrance Door -L.M.I.", sheets 1 through 11 of 11, prepared by AL-Farooq Corporation, dated 10/20/03 and last revised on MAR 29, 2004, signed and sealed by Dr. Humayoun Farooq, P.E.
- B. TESTS (transferred from file # 04-0227.02)
- 1. Test reports on 1) Air Infiltration Test, per FBC, TAS 202-94
  - 2) Uniform Static Air Pressure Test, Loading per FBC, TAS 202-94
  - 3) Forced Entry Test, per FBC 2411 3.2.1 and TAS 202-94

along with installation diagram of an aluminum outswing door, prepared by Hurricane Test Laboratory, Inc., Test Report No. **HTL- 0231-0415-03**, with Specimen # 3, dated 08/05/03, signed and sealed by Vinu J. Abraham, P.E.

- 2. Test reports on 1) Air Infiltration Test, per FBC, TAS 202-94
  - 2) Uniform Static Air Pressure Test, Loading per FBC, TAS 202-94
  - 3) Forced Entry Test, per FBC 2411 3.2.1 and TAS 202-94

along with installation diagram of an aluminum outswing door, prepared by Hurricane Test Laboratory, Inc., Test Report No. **HTL- 0231-0711-02**, with Specimen # 1, dated 08/05/03, signed and sealed by Vinu J. Abraham, P.E.

- 3. Test reports on 1) Large Missile Impact Test per FBC, TAS 201-94
  - 2) Cyclic Wind Pressure Loading per FBC, TAS 203-94

along with installation diagram of an aluminum outswing door, prepared by Hurricane Test Laboratory, Inc., Test Report No.**HTL-0231-1203-02** with Specimen # 1, dated 08/05/03, signed and sealed by Vinu J. Abraham, P.E.

- 4. Test reports on 1) Air Infiltration Test, per FBC, TAS 202-94 along with installation diagram of an aluminum outswing door, prepared by Hurricane Test Laboratory, Inc., Test Report No. **HTL- 0231-0711-02**, with Specimen # 2, dated 08/05/03, signed and sealed by Vinu J. Abraham, P.E.
- Test reports on 1) Uniform Static Air Pressure Test, Loading per FBC, TAS 202-94 along with installation diagram of an aluminum outswing door, prepared by Hurricane Test Laboratory, Inc., Test Report No. **HTL- 0231-0306-03**, with Specimen # 1, dated 08/05/03, signed and sealed by Vinu J. Abraham, P.E.
- Test reports on 1) Forced Entry Test, per FBC 2411 3.2.1 and TAS 202-94 along with installation diagram of an aluminum outswing door, prepared by Hurricane Test Laboratory, Inc., Test Report No. **HTL- 0231-0529-03**, with Specimen # 1, dated 08/05/03, signed and sealed by Vinu J. Abraham, P.E.
- 7. Test reports on 1) Large Missile Impact Test per FBC, TAS 201-94
  - 2) Cyclic Wind Pressure Loading per FBC, TAS 203-94 along with installation diagram of an aluminum outswing door, prepared by Hurricane Test Laboratory, Inc., Test Report No.**HTL-0231-0415-03** with Specimen # 2, dated 08/05/03, signed and sealed by Vinu J. Abraham, P.E.

Ishag I. Chanda

Ishaq I. Chanda, P. E.
Product Control Examiner
NOA No 09-0518.09
Expiration Date: June 10, 2010
Approval Date: June 10, 2009

## NOTICE OF ACCEPTANCE: EVIDENCE PAGE

- TESTS Continue: (transferred from file # 04-0227.02)
   Test reports on 1) Large Missile Impact Test per FBC, TAS 201-94

   2) Cyclic Wind Pressure Loading per FBC, TAS 203-94
   along with installation diagram of an aluminum outswing door, prepared by Hurricane Test Laboratory, Inc., Test Report No.HTL-0231-0415-03 with Specimen # 2, dated 08/05/03, signed and sealed by Vinu J. Abraham, P.E.
- 9. Test reports on 1) Uniform Static Air Pressure Test, Loading per FBC, TAS 202-94 along with installation diagram of an aluminum outswing door, prepared by Hurricane Test Laboratory, Inc., Test Report No. **HTL- 0231-0529-03**, with Specimen # 1, dated 08/05/03, signed and sealed by Vinu J. Abraham, P.E.
- 10. Test reports on 1) Air Infiltration Test, per FBC, TAS 202-94
  - 2) Uniform Static Air Pressure Test, Loading per FBC, TAS 202-94
  - 3) Forced Entry Test, per FBC 2411 3.2.1 and TAS 202-94 along with installation diagram of an aluminum outswing door, prepared by Hurricane Test Laboratory, Inc., Test Report No. **HTL- 0231-0923-02**, with Specimen # 1, dated 08/05/03, signed and sealed by Vinu J. Abraham, P.E.
- 11. Test reports on 1) Large Missile Impact Test per FBC, TAS 201-94
  2) Cyclic Wind Pressure Loading per FBC, TAS 203-94
  along with installation diagram of an aluminum outswing door, prepared by Hurricane Test Laboratory, Inc., Test Report No.HTL-0231-0641-03 with Specimen # 1, dated 08/05/03, signed and sealed by Vinu J. Abraham, P.E.
- 12. Test reports on 1) Large Missile Impact Test per FBC, TAS 201-94
  2) Cyclic Wind Pressure Loading per FBC, TAS 203-94
  along with installation diagram of an aluminum outswing door, prepared by Hurricane Test Laboratory, Inc., Test Report No.HTL-0231-0415-03 with Specimen # 4, dated 08/05/03, signed and sealed by Vinu J. Abraham, P.E.
- Test reports on 1) Uniform Static Air Pressure Test, Loading per FBC, TAS 202-94

  2) Forced Entry Test, per FBC 2411 3.2.1 and TAS 202-94

  along with installation diagram of an aluminum outswing door, prepared by Hurricane
  Test Laboratory, Inc., Test Report No.HTL-0231-0415-03 with Specimen # 3, dated
  08/05/03, signed and sealed by Vinu J. Abraham, P.E.
- C. CALCULATIONS (transferred from file # 04-0227.02)
  - 1. Comparative analysis and structural analysis, prepared by AL-Farooq Corporation, dated 12/29/03, signed and sealed by Dr. Humayoun Farooq, P.E.
  - 2. Complies w/ASTME-1300-02 & 04 (Except Glass type 1 &2)
- D. QUALITY ASSURANCE
  - 1. Miami Dade Building Code Compliance Office (BCCO).

Ishaq I. Chanda, P. E.
Product Control Examiner
NOA No 09-0518.09
Expiration Date: June 10, 2010

Approval Date: June 10, 2009

Ishag ). (hand

## **NOTICE OF ACCEPTANCE: EVIDENCE PAGE**

#### E. MATERIAL CERTIFICATIONS

- 1. Notice of Acceptance No. **05-1208.02** issued to "E.I. DuPont Denemours" for "DuPont Butacite ® PVB", expiring on 12/11/10.
- 2. Notice of Acceptance No. **06-0216.06** issued to Solutia, for "Saflex IIIG clear & color interlayer", expiring on 05/21/2011
- 3. Notice of Acceptance No. **08-0206.01** issued to Solutia, for "Saflex HP glass interlayer", expiring on 04/17/2013
- 4. Notice of Acceptance No. **07-1116.11** issued to Security Impact Glass Holding L.L.C, for "Saf-Glas Polycarbonate Laminate", expiring on 12/16/2012

## F. STATEMENTS (transferred from file # 04-0227.02)

- 1. Statement letter of code compliance, dated December 18, 2003, signed and sealed by Dr. Dr. Humayoun Farooq, P.E.
- 2. Statement letter of no financial interest, dated December 29, 2003, signed and sealed by Dr. Humayoun Farooq, P.E.
- 3. BCCO anchor verification with design Pressure (Dp) reduction by 1.33 to comply with FBC 2007.


## G. OTHER


- 1. This NOA revises NOA # **04-0227.02**, expiring June 10, 2009
- 2. Test proposal dated 05-18-09 approved by BCCO
- 3. One year conditional approval, subjected to successful verification test.
- 4. Letter dated 03/24/04 from the consultant stating that the product is in compliance with the Florida Building Code (transferred from file #04-0227.02)

Islag I. Chanda


Ishaq I. Chanda, P. E. Product Control Examiner NOA No 09-0518.09 Expiration Date: June 10, 2010

Approval Date: June 10, 2009

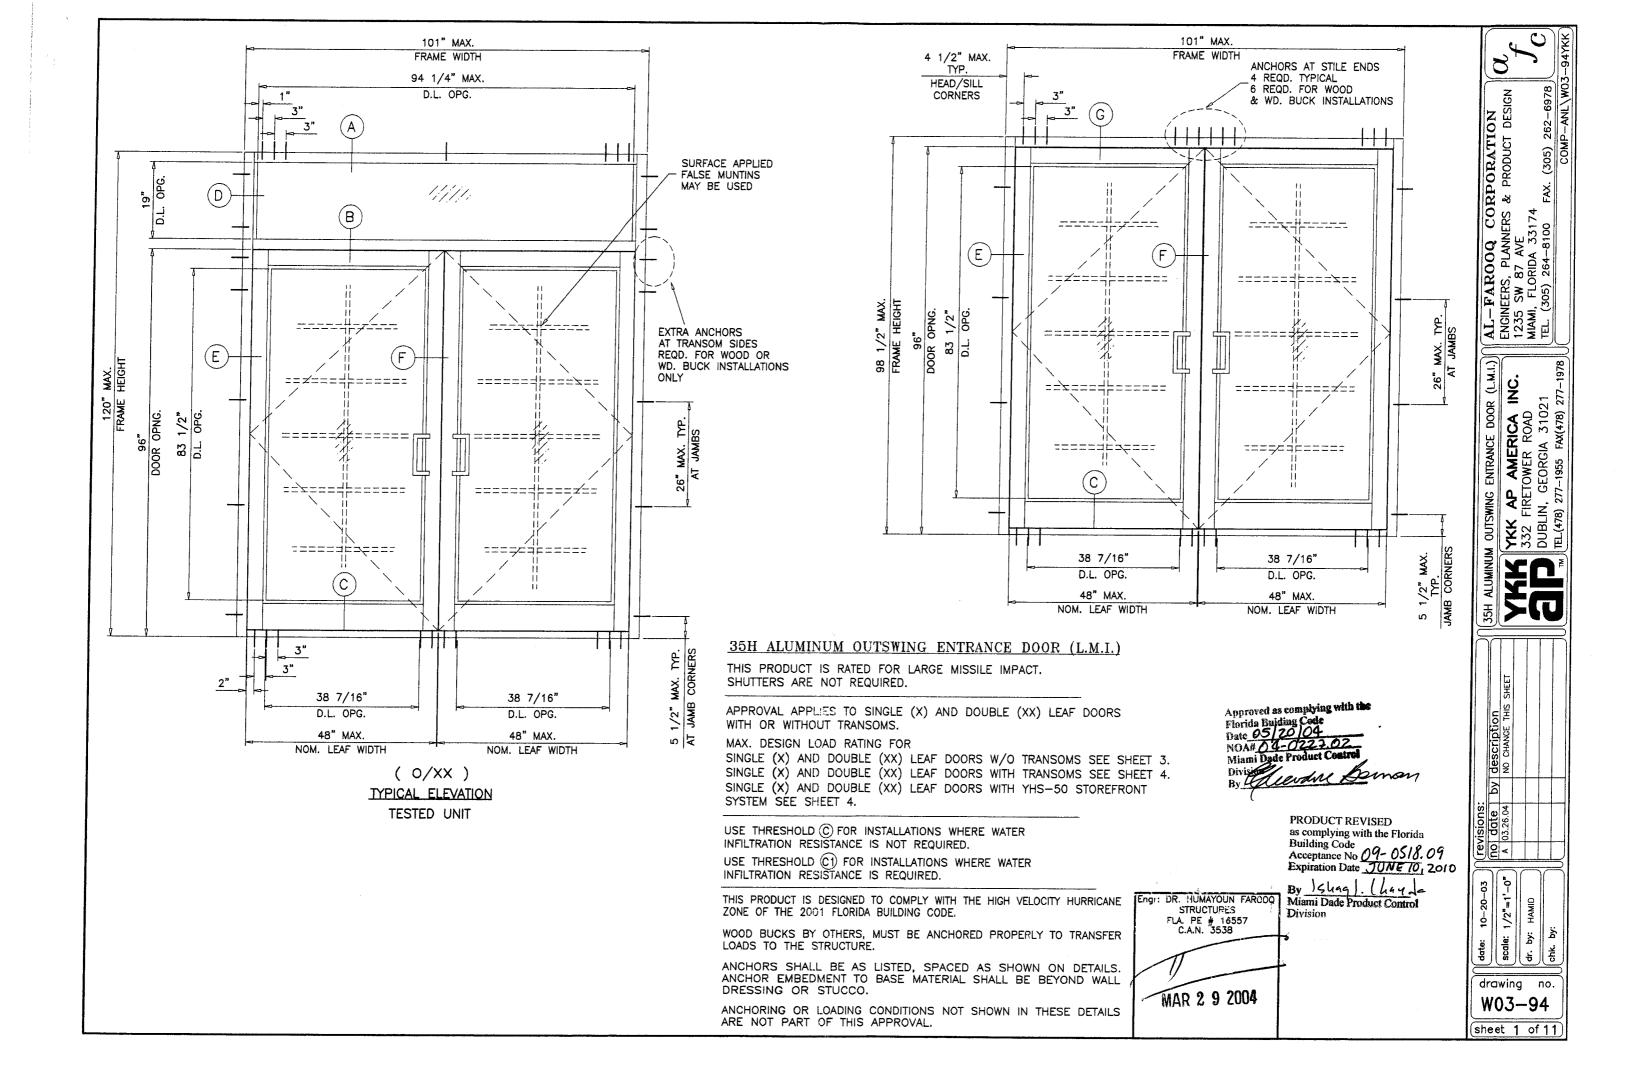

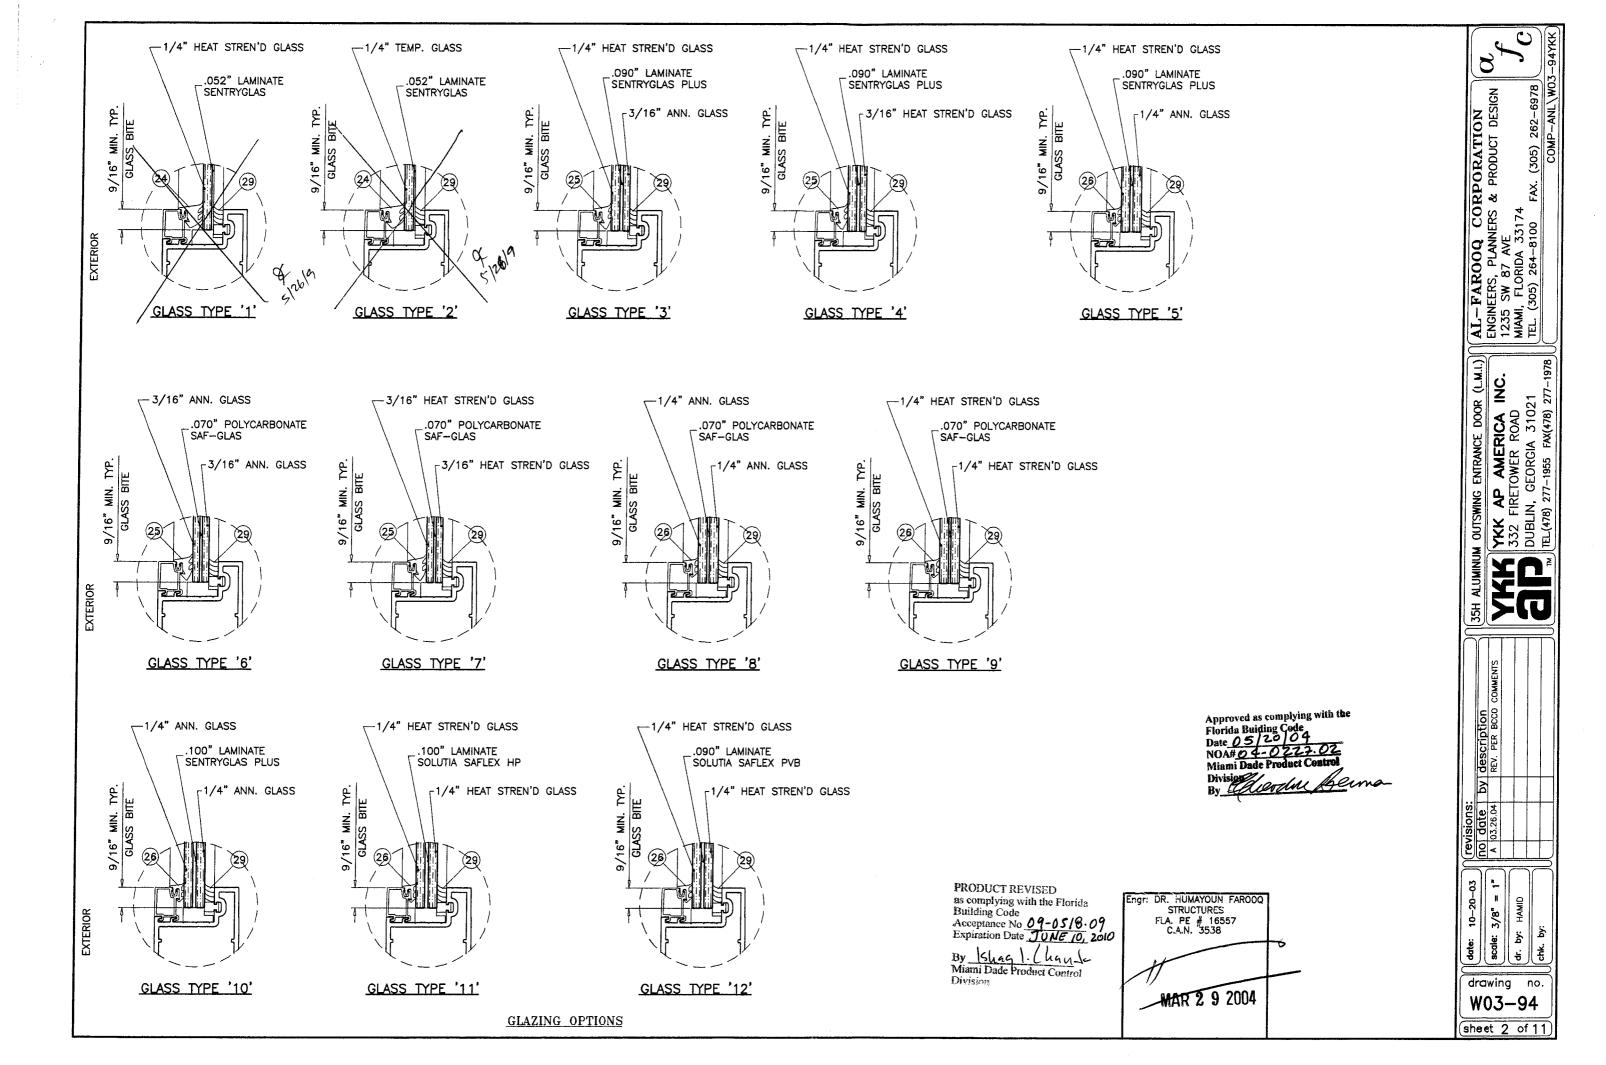

SINGLE OR DOUBLE ENTRANCE DOORS W/O TRANSOM DESIGN LOAD CAPACITY - PSF																	
NOMIN	AL DIMS.	GLASS		GLASS	TYPE	GLASS		GLASS '4' &		GLASS '6' &		GLASS '8', '9'		GLASS		GLASS	
LEAF WIDTH INCHES	DOOR HEIGHT INCHES	EXT.(+)	INT.(-)	EXT.(+)	INT.(-)	EXT.(+)	INT.(-)	EXT.(+)	INT.(-)	EXT.(+)	INT.(-)	EXT.(+)	INT.(-)	EXT.(+)	INT.(-)	EXT.(+)	INT.(-)
30"		70.0	90.0	70.0	90.0	68.6	86.3	68.6	86.3	70.0	90.0	70.0	90.0	70.0	90.0	60.0	65.0
36"	80"	70.0	90.0	70.0	90.0	68.6	86.3	68.6	86.3	70.0	90.0	70.0	90.0	70.0	90.0	60.0	65.0
42"	<b>A</b> U	70.0	86.0	70.0	90.0	68.2	86.0	68.6	86.3	70.0	80.2	70.0	90.0	70.0	90.0	60.0	65.0
48"		70.0	78.6	70.0	90.0	68.2	78.6	68.6	86.3	62.8	62.8	70.0	90.0	70.0	90.0	60.0	65.0
30"		70.0	90.0	70.0	90.0	68.6	86.3	68.6	86.3	70.0	90.0	70.0	90.0	70.0	90.0	60.0	65.0
36"	84"	70.0	90.0	70.0	90.0	68.6	86.3	68.6	86.3	70.0	90.0	70.0	90.0	70.0	90.0	60.0	65.0
42"	04	70.0	81.2	70.0	90.0	68.6	81.2	68.6	86.3	70.0	76.0	70.0	90.0	70.0	90.0	60.0	65.0
48"		70.0	74.2	70.0	90.0	68.6	74.2	68.6	86.3	59.4	59.4	70.0	90.0	70.0	90.0	60.0	65.0
30"		70.0	90.0	70.0	90.0	68.6	86.3	68.6	86.3	70.0	90.0	70.0	90.0	70.0	90.0	60.0	65.0
36"	90"	70.0	90.0	70.0	90.0	68.6	86.3	68.6	86.3	70.0	90.0	70.0	90.0	70.0	90.0	60.0	65.0
42"	90	70.0	75.2	70.0	90.0	68.6	75.2	68.6	86.3	70.0	70.5	70.0	90.0	70.0	90.0	60.0	65.0
48"		_		_	-	-	-	_	-	-	-	70.0	89.8	70.0	90.0	_	-
30"		70.0	90.0	70.0	90.0	68.6	86.3	68.6	86.3	70.0	90.0	70.0	90.0	70.0	90.0	60.0	65.0
36"	96"	70.0	90.0	70.0	90.0	68.6	86.3	68.6	86.3	70.0	90.0	70.0	90.0	70.0	90.0	60.0	65.0
42"	30	70.0	71.0	70.0	90.0	68.6	71.0	68.6	86.3	68.8	68.8	70.0	90.0	70.0	90.0	60.0	65.0
48"	j	-	- 1	-	-	-	-	-	-	-	- 1	70.0	87.5	70.0	90.0	_	-

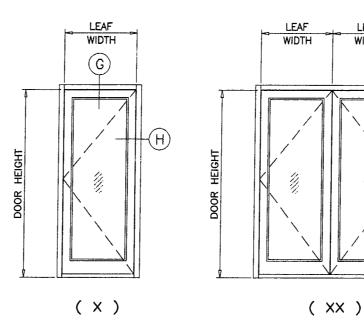

Approved as complying with the Florida Building Code
Date 05 | 20 | 04
NOA# 04 - 0227 02
Miami Dade Product Control
Division
By Week Week Week Week Week

PRODUCT REVISED
as complying with the Florida
Building Code
Acceptance No 09-05 18-09
Expiration Date JUNE 10, 2010

LEAF

WIDTH

By Shag L. Chan & Miami Dade Product Control Division

Engr: DR. HUMAYOUN FAROCO STRUCTURES	ļ
FLA. PE # 16557 C.A.N. 3539	
C.A.N. 5555	1
1	
MAR 2 9 2004	

AL-FAROOQ CORPORATION
ENGINEERS, PLANNERS & PRODUCT DESIGN
1235 SW 87 AVE
MIAMI, FLORIDA 33174
TEL. (305) 264-8100 FAX. (305) 262-6978 FAX. (305) 262-6978 COMP-ANL\WO 35H ALUMINUM OUTSWING ENTRANCE DOOR (L.M.I.)


YKK AP AMERICA INC.
332 FIRETOWER ROAD
DUBLIN, GEORGIA 31021
The term of the control of the con revisions:

no date by description

A 03.26.04 REV. PER BCCO C date: 10-20-03 ₹ <del>₹</del>


drawing no.
W03-94
Sheet 3 of 11

INCHES   INCHES   EXT. (+)   INT. (-)   EXT. (+)   INT. (-)			MULI	LION LOAD CAPACITY-PSF					
SEA   SEA   SEA   SEA   SEA   SEA   SEA			· I	W/O RE	INFORCING	WITH R	WITH REINFORCING		
51"         55.0         70.0         70.0         90.0           57"         55.0         70.0         70.0         90.0           60"         55.0         70.0         70.0         90.0           68"         55.0         70.0         70.0         90.0           66"         55.0         70.0         70.0         90.0           69"         55.0         70.0         70.0         90.0           72"         55.0         70.0         70.0         90.0           75"         55.0         70.0         70.0         90.0           75"         55.0         70.0         70.0         90.0           75"         55.0         70.0         70.0         90.0           55.1"         55.0         70.0         70.0         90.0           51"         55.0         70.0         70.0         90.0           57"         55.0         70.0         70.0         90.0           60"         55.0         70.0         70.0         90.0           66"         55.0         70.0         70.0         90.0           72"         55.0         70.0         70.0         90.0		INCHES	INCHES	EXT. (+) INT. (-) EXT.			) INT. (-)		
54"         55.0         70.0         70.0         90.0           57"         55.0         70.0         70.0         90.0           60"         55.0         70.0         70.0         90.0           68"         55.0         70.0         70.0         90.0           69"         55.0         70.0         70.0         90.0           75"         55.0         70.0         70.0         90.0           78"         55.0         70.0         70.0         90.0           78"         55.0         70.0         70.0         90.0           78"         55.0         70.0         70.0         90.0           51"         55.0         70.0         70.0         90.0           54"         55.0         70.0         70.0         90.0           60"         55.0         70.0         70.0         90.0           63"         55.0         70.0         70.0         90.0           66"         55.0         70.0         70.0         90.0           69"         55.0         70.0         70.0         90.0           72"         55.0         70.0         70.0         90.0 </td <th></th> <td>48"</td> <td></td> <td>55.0</td> <td>70.0</td> <td>70.0</td> <td>90.0</td>		48"		55.0	70.0	70.0	90.0		
57"         55.0         70.0         70.0         90.0           60"         65.0         70.0         70.0         90.0           66"         55.0         70.0         70.0         90.0           66"         55.0         70.0         70.0         90.0           68"         55.0         70.0         70.0         90.0           72"         55.0         70.0         70.0         90.0           75"         55.0         70.0         70.0         90.0           78"         55.0         70.0         70.0         90.0           48"         55.0         70.0         70.0         90.0           51"         55.0         70.0         70.0         90.0           51"         55.0         70.0         70.0         90.0           55"         70.0         70.0         90.0         90.0           60"         55.0         70.0         70.0         90.0           68"         55.0         70.0         70.0         90.0           72"         55.0         70.0         70.0         90.0           75"         -         -         70.0         90.0		51"		55.0	70.0	70.0	90.0		
S0"   96"   55.0   70.0   70.0   90.0		54"		55.0	70.0	70.0	90.0		
63"         55.0         70.0         70.0         90.0           66"         55.0         70.0         70.0         90.0           68"         55.0         70.0         70.0         90.0           72"         55.0         70.0         70.0         90.0           78"         55.0         70.0         70.0         90.0           48"         55.0         70.0         70.0         90.0           51"         55.0         70.0         70.0         90.0           57"         55.0         70.0         70.0         90.0           60"         55.0         70.0         70.0         90.0           63"         55.0         70.0         70.0         90.0           66"         55.0         70.0         70.0         90.0           72"         55.0         70.0         70.0         90.0           72"         55.0         70.0         70.0         90.0           75"         -         -         70.0         90.0           75"         -         -         70.0         90.0           72"         -         -         70.0         90.0	ı			55.0	70.0	70.0	90.0		
65"   55.0   70.0   70.0   90.0	ı	60"	96"	55.0	70.0	70.0	90.0		
69"         55.0         70.0         70.0         90.0           72"         55.0         70.0         70.0         90.0           78"         55.0         70.0         70.0         90.0           48"         55.0         70.0         70.0         90.0           51"         55.0         70.0         70.0         90.0           54"         55.0         70.0         70.0         90.0           57"         55.0         70.0         70.0         90.0           60"         55.0         70.0         70.0         90.0           68"         55.0         70.0         70.0         90.0           68"         55.0         70.0         70.0         90.0           68"         55.0         70.0         70.0         90.0           72"         55.0         70.0         70.0         90.0           78"         -         -         70.0         90.0           78"         -         -         70.0         90.0           51"         55.0         70.0         70.0         90.0           54"         55.0         70.0         70.0         90.0		63"		55.0	70.0	70.0	90.0		
72"         55.0         70.0         70.0         90.0           75"         55.0         70.0         70.0         90.0           55.0         70.0         70.0         90.0           51"         55.0         70.0         70.0         90.0           51"         55.0         70.0         70.0         90.0           57"         55.0         70.0         70.0         90.0           60"         55.0         70.0         70.0         90.0           63"         55.0         70.0         70.0         90.0           66"         55.0         70.0         70.0         90.0           68"         55.0         70.0         70.0         90.0           72"         55.0         70.0         70.0         90.0           75"         -         -         70.0         90.0           75"         -         -         70.0         90.0           72"         -         -         70.0         90.0           78"         -         -         70.0         90.0           51"         55.0         70.0         70.0         90.0           60" <td< td=""><th>-</th><td>1</td><td></td><td>55.0</td><td>70.0</td><td>70.0</td><td>90.0</td></td<>	-	1		55.0	70.0	70.0	90.0		
75"         55.0         70.0         70.0         90.0           48"         55.0         70.0         70.0         90.0           51"         55.0         70.0         70.0         90.0           54"         55.0         70.0         70.0         90.0           60"         55.0         70.0         70.0         90.0           63"         55.0         70.0         70.0         90.0           68"         55.0         70.0         70.0         90.0           68"         55.0         70.0         70.0         90.0           69"         55.0         70.0         70.0         90.0           72"         55.0         70.0         70.0         90.0           75"         -         -         70.0         90.0           75"         -         -         70.0         90.0           75"         -         -         70.0         90.0           51"         55.0         70.0         70.0         90.0           51"         55.0         70.0         70.0         90.0           66"         55.0         70.0         70.0         90.0	١	1	1	55.0	70.0	70.0	90.0		
78"         55.0         70.0         70.0         90.0           48"         55.0         70.0         70.0         90.0           51"         55.0         70.0         70.0         90.0           54"         55.0         70.0         70.0         90.0           60"         55.0         70.0         70.0         90.0           63"         55.0         70.0         70.0         90.0           68"         55.0         70.0         70.0         90.0           68"         55.0         70.0         70.0         90.0           72"         55.0         70.0         70.0         90.0           75"         -         -         70.0         90.0           78"         -         -         70.0         90.0           51"         55.0         70.0         70.0         90.0           51"         55.0         70.0         70.0         90.0           55"         70.0         70.0         90.0           55"         70.0         70.0         90.0           55"         70.0         70.0         90.0           60"         55.0         70.0		1		55.0	70.0	70.0	90.0		
48"       55.0       70.0       70.0       90.0         54"       55.0       70.0       70.0       90.0         57"       55.0       70.0       70.0       90.0         60"       55.0       70.0       70.0       90.0         68"       55.0       70.0       70.0       90.0         66"       55.0       70.0       70.0       90.0         69"       55.0       70.0       70.0       90.0         72"       55.0       70.0       70.0       90.0         75"       —       —       70.0       90.0         78"       —       —       70.0       90.0         48"       55.0       70.0       70.0       90.0         54"       55.0       70.0       70.0       90.0         63"       108"       55.0       70.0       70.0       90.0         63"       108"       55.0       70.0       70.0       90.0         66"       55.0       70.0       70.0       90.0         66"       55.0       70.0       70.0       90.0         75"       —       —       70.0       90.0 <t< td=""><th>-</th><td></td><td></td><td>55.0</td><td>70.0</td><td>70.0</td><td>90.0</td></t<>	-			55.0	70.0	70.0	90.0		
51"       55.0       70.0       70.0       90.0         57"       55.0       70.0       70.0       90.0         60"       55.0       70.0       70.0       90.0         68"       55.0       70.0       70.0       90.0         69"       55.0       70.0       70.0       90.0         72"       55.0       70.0       70.0       90.0         78"       —       —       70.0       90.0         48"       55.0       70.0       70.0       90.0         51"       55.0       70.0       70.0       90.0         51"       55.0       70.0       70.0       90.0         51"       55.0       70.0       70.0       90.0         57"       55.0       70.0       70.0       90.0         60"       55.0       70.0       70.0       90.0         63"       108"       55.0       70.0       70.0       90.0         66"       55.0       70.0       70.0       90.0       90.0         66"       55.0       70.0       70.0       90.0       90.0         75"       —       —       70.0	١		<del> </del>	55.0	70.0	70.0	90.0		
54"       55.0       70.0       70.0       90.0         60"       55.0       70.0       70.0       90.0         63"       55.0       70.0       70.0       90.0         66"       55.0       70.0       70.0       90.0         69"       55.0       70.0       70.0       90.0         72"       55.0       70.0       70.0       90.0         75"       -       -       70.0       90.0         78"       -       -       70.0       90.0         48"       55.0       70.0       70.0       90.0         51"       55.0       70.0       70.0       90.0         54"       55.0       70.0       70.0       90.0         55"       55.0       70.0       70.0       90.0         63"       55.0       70.0       70.0       90.0         66"       55.0       70.0       70.0       90.0         66"       55.0       70.0       70.0       90.0         72"       -       -       70.0       90.0         75"       -       -       70.0       90.0         55"       70.0				55.0	70.0	70.0	90.0		
57"       55.0       70.0       70.0       90.0         60"       55.0       70.0       70.0       90.0         66"       55.0       70.0       70.0       90.0         69"       55.0       70.0       70.0       90.0         72"       55.0       70.0       70.0       90.0         78"       -       -       70.0       90.0         48"       55.0       70.0       70.0       90.0         51"       55.0       70.0       70.0       90.0         54"       55.0       70.0       70.0       90.0         55"       55.0       70.0       70.0       90.0         66"       55.0       70.0       70.0       90.0         66"       55.0       70.0       70.0       90.0         66"       55.0       70.0       70.0       90.0         72"       -       -       70.0       90.0         72"       -       -       70.0       90.0         75"       -       -       70.0       90.0         75"       -       -       70.0       90.0         75"       -       - </td <th></th> <td></td> <td></td> <td>55.0</td> <td>70.0</td> <td>70.0</td> <td>90.0</td>				55.0	70.0	70.0	90.0		
60"       102"       55.0       70.0       70.0       90.0         66"       55.0       70.0       70.0       90.0         69"       55.0       70.0       70.0       90.0         72"       55.0       70.0       70.0       90.0         75"       —       —       70.0       90.0         48"       55.0       70.0       70.0       90.0         51"       55.0       70.0       70.0       90.0         54"       55.0       70.0       70.0       90.0         63"       55.0       70.0       70.0       90.0         63"       55.0       70.0       70.0       90.0         66"       55.0       70.0       70.0       90.0         68"       55.0       70.0       70.0       90.0         68"       55.0       70.0       70.0       90.0         72"       —       —       70.0       90.0         72"       —       —       70.0       90.0         75"       —       —       70.0       90.0         75"       —       —       70.0       90.0         75"					<del> </del>	<del> </del>	90.0		
63"       55.0       70.0       70.0       90.0         66"       55.0       70.0       70.0       90.0         69"       55.0       70.0       70.0       90.0         72"       55.0       70.0       70.0       90.0         78"       —       —       70.0       90.0         48"       55.0       70.0       70.0       90.0         51"       55.0       70.0       70.0       90.0         54"       55.0       70.0       70.0       90.0         60"       55.0       70.0       70.0       90.0         63"       55.0       70.0       70.0       90.0         66"       55.0       70.0       70.0       90.0         66"       55.0       70.0       70.0       90.0         72"       —       —       70.0       90.0         75"       —       —       70.0       90.0         75"       —       —       70.0       90.0         75"       —       —       70.0       90.0         75"       —       —       70.0       90.0         51"       55.0       70.0 </td <th></th> <td></td> <td>   </td> <td></td> <td><del> </del></td> <td></td> <td>90.0</td>					<del> </del>		90.0		
63"         55.0         70.0         70.0         90.0           69"         55.0         70.0         70.0         90.0           72"         55.0         70.0         70.0         90.0           75"         —         —         70.0         90.0           78"         —         —         70.0         90.0           48"         55.0         70.0         70.0         90.0           51"         55.0         70.0         70.0         90.0           54"         55.0         70.0         70.0         90.0           57"         55.0         70.0         70.0         90.0           60"         55.0         70.0         70.0         90.0           63"         55.0         70.0         70.0         90.0           66"         55.0         70.0         70.0         90.0           72"         —         —         —         70.0         90.0           75"         —         —         —         70.0         90.0           48"         55.0         70.0         70.0         90.0           54"         55.0         70.0         70.0         90			102"		<del> </del>	<del> </del>	90.0		
69"         55.0         70.0         70.0         90.0           72"         55.0         70.0         70.0         90.0           75"         —         —         70.0         90.0           78"         —         —         70.0         90.0           48"         55.0         70.0         70.0         90.0           51"         55.0         70.0         70.0         90.0           54"         55.0         70.0         70.0         90.0           60"         55.0         70.0         70.0         90.0           63"         55.0         70.0         70.0         90.0           66"         55.0         70.0         70.0         90.0           69"         55.0         70.0         70.0         90.0           72"         —         —         70.0         90.0           75"         —         —         70.0         90.0           75"         —         —         70.0         90.0           75"         —         —         70.0         90.0           51"         55.0         70.0         70.0         90.0           55"	П					70.0	90.0		
72"         55.0         70.0         70.0         90.0           75"         —         —         70.0         90.0           78"         —         —         70.0         90.0           48"         55.0         70.0         70.0         90.0           51"         55.0         70.0         70.0         90.0           54"         55.0         70.0         70.0         90.0           57"         55.0         70.0         70.0         90.0           60"         55.0         70.0         70.0         90.0           66"         55.0         70.0         70.0         90.0           66"         55.0         70.0         70.0         90.0           66"         55.0         70.0         70.0         90.0           72"         —         —         70.0         90.0           75"         —         —         70.0         90.0           48"         55.0         70.0         70.0         90.0           54"         55.0         70.0         70.0         90.0           55.0         70.0         70.0         90.0           66" <td< td=""><th>Ш</th><td></td><td> </td><td></td><td><del> </del></td><td><del>                                     </del></td><td>90.0</td></td<>	Ш				<del> </del>	<del>                                     </del>	90.0		
75"         —         —         —         70.0         90.0           48"         —         —         —         70.0         90.0           51"         55.0         70.0         70.0         90.0           54"         55.0         70.0         70.0         90.0           57"         55.0         70.0         70.0         90.0           60"         55.0         70.0         70.0         90.0           66"         55.0         70.0         70.0         90.0           66"         55.0         70.0         70.0         90.0           69"         55.0         70.0         70.0         90.0           72"         —         —         70.0         90.0           75"         —         —         70.0         90.0           48"         55.0         70.0         70.0         90.0           51"         55.0         70.0         70.0         90.0           57"         55.0         70.0         70.0         90.0           60"         55.0         70.0         70.0         90.0           63"         55.0         70.0         70.0         90						<del>                                     </del>	<del> </del>		
78"         —         —         70.0         90.0           48"         55.0         70.0         70.0         90.0           51"         55.0         70.0         70.0         90.0           54"         55.0         70.0         70.0         90.0           57"         55.0         70.0         70.0         90.0           60"         55.0         70.0         70.0         90.0           63"         55.0         70.0         70.0         90.0           66"         55.0         70.0         70.0         90.0           69"         55.0         70.0         70.0         90.0           75"         —         —         70.0         90.0           78"         —         —         70.0         90.0           48"         55.0         70.0         70.0         90.0           51"         55.0         70.0         70.0         90.0           57"         55.0         70.0         70.0         90.0           60"         55.0         70.0         70.0         90.0           66"         55.0         70.0         70.0         90.0	Ш		}	55.0	70.0				
48"       55.0       70.0       70.0       90.0         51"       55.0       70.0       70.0       90.0         54"       55.0       70.0       70.0       90.0         57"       55.0       70.0       70.0       90.0         60"       55.0       70.0       70.0       90.0         66"       55.0       70.0       70.0       90.0         69"       55.0       70.0       70.0       90.0         72"       -       -       70.0       90.0         75"       -       -       70.0       90.0         48"       55.0       70.0       70.0       90.0         51"       55.0       70.0       70.0       90.0         54"       55.0       70.0       70.0       90.0         60"       55.0       70.0       70.0       90.0         66"       55.0       70.0       70.0       90.0         66"       55.0       70.0       70.0       90.0         66"       55.0       70.0       70.0       90.0         72"       -       -       70.0       90.0         75"       -	Ш		ļ-	-	-		<del>                                     </del>		
51"     55.0     70.0     70.0     90.0       54"     55.0     70.0     70.0     90.0       57"     55.0     70.0     70.0     90.0       60"     55.0     70.0     70.0     90.0       63"     55.0     70.0     70.0     90.0       66"     55.0     70.0     70.0     90.0       69"     55.0     70.0     70.0     90.0       72"     -     -     70.0     90.0       78"     -     -     70.0     90.0       51"     55.0     70.0     70.0     90.0       54"     55.0     70.0     70.0     90.0       57"     55.0     70.0     70.0     90.0       60"     55.0     70.0     70.0     90.0       66"     55.0     70.0     70.0     90.0       66"     55.0     70.0     70.0     90.0       66"     55.0     70.0     70.0     90.0       75"     -     -     70.0     90.0       66"     55.0     70.0     70.0     90.0       75"     -     -     70.0     90.0       75"     -     -     70.0     90.0	$\parallel$					<del> </del>	<del> </del>		
54"       55.0       70.0       70.0       90.0         57"       55.0       70.0       70.0       90.0         60"       55.0       70.0       70.0       90.0         66"       55.0       70.0       70.0       90.0         69"       55.0       70.0       70.0       90.0         72"       —       —       70.0       90.0         78"       —       —       70.0       90.0         51"       55.0       70.0       70.0       90.0         54"       55.0       70.0       70.0       90.0         57"       55.0       70.0       70.0       90.0         60"       55.0       70.0       70.0       90.0         66"       55.0       70.0       70.0       90.0         66"       55.0       70.0       70.0       90.0         69"       —       —       —       70.0       90.0         72"       —       —       —       70.0       90.0         75"       —       —       —       70.0       90.0         68"       —       —       —       70.0       90.0 </td <th><math>\parallel</math></th> <td></td> <td>-</td> <td></td> <td></td> <td><del></del></td> <td></td>	$\parallel$		-			<del></del>			
57"       55.0       70.0       70.0       90.0         60"       55.0       70.0       70.0       90.0         66"       55.0       70.0       70.0       90.0         69"       55.0       70.0       70.0       90.0         72"       —       —       70.0       90.0         78"       —       —       70.0       90.0         48"       55.0       70.0       70.0       90.0         51"       55.0       70.0       70.0       90.0         54"       55.0       70.0       70.0       90.0         57"       55.0       70.0       70.0       90.0         60"       55.0       70.0       70.0       90.0         66"       55.0       70.0       70.0       90.0         66"       55.0       70.0       70.0       90.0         66"       55.0       70.0       70.0       90.0         72"       —       —       —       70.0       90.0         75"       —       —       —       70.0       90.0         48"       —       —       —       70.0       90.0 <tr< td=""><th>Н</th><td>i</td><td>\  </td><td></td><td></td><td></td><td></td></tr<>	Н	i	\ 						
60"       108"       55.0       70.0       70.0       90.0         66"       55.0       70.0       70.0       90.0         69"       55.0       70.0       70.0       90.0         72"       —       —       70.0       90.0         78"       —       —       70.0       90.0         48"       55.0       70.0       70.0       90.0         51"       55.0       70.0       70.0       90.0         51"       55.0       70.0       70.0       90.0         57"       55.0       70.0       70.0       90.0         60"       55.0       70.0       70.0       90.0         66"       55.0       70.0       70.0       90.0         66"       55.0       70.0       70.0       90.0         66"       55.0       70.0       70.0       90.0         72"       —       —       —       70.0       90.0         75"       —       —       70.0       90.0         75"       —       —       70.0       90.0         48"       —       —       70.0       90.0         54"	Ш	1	-						
63"       55.0       70.0       70.0       90.0         66"       55.0       70.0       70.0       90.0         69"       55.0       70.0       70.0       90.0         72"       —       —       70.0       90.0         78"       —       —       70.0       90.0         48"       55.0       70.0       70.0       90.0         51"       55.0       70.0       70.0       90.0         54"       55.0       70.0       70.0       90.0         57"       55.0       70.0       70.0       90.0         60"       55.0       70.0       70.0       90.0         66"       55.0       70.0       70.0       90.0         66"       55.0       70.0       70.0       90.0         72"       —       —       70.0       90.0         75"       —       —       70.0       90.0         48"       —       —       70.0       90.0         54"       —       —       70.0       90.0         54"       —       —       70.0       90.0         55"       —       — <t< td=""><th><math>\parallel</math></th><td>1</td><td>-</td><td></td><td></td><td></td><td><del> </del></td></t<>	$\parallel$	1	-				<del> </del>		
66"       55.0       70.0       70.0       90.0         69"       55.0       70.0       70.0       90.0         72"       —       —       70.0       90.0         78"       —       —       70.0       90.0         48"       55.0       70.0       70.0       90.0         51"       55.0       70.0       70.0       90.0         54"       55.0       70.0       70.0       90.0         57"       55.0       70.0       70.0       90.0         60"       55.0       70.0       70.0       90.0         66"       55.0       70.0       70.0       90.0         69"       —       —       70.0       90.0         72"       —       —       70.0       90.0         48"       —       —       70.0       90.0         54"       —       —       70.0       90.0         54"       —       —       70.0       90.0         55"       —       —       70.0       90.0         75"       —       —       70.0       90.0         54"       —       —       70.0	П	1	108"				<b></b>		
69"       55.0       70.0       70.0       90.0         72"       —       —       70.0       90.0         75"       —       —       70.0       90.0         78"       —       —       70.0       90.0         48"       55.0       70.0       70.0       90.0         51"       55.0       70.0       70.0       90.0         57"       55.0       70.0       70.0       90.0         60"       55.0       70.0       70.0       90.0         63"       55.0       70.0       70.0       90.0         66"       55.0       70.0       70.0       90.0         69"       —       —       70.0       90.0         72"       —       —       70.0       90.0         75"       —       —       70.0       90.0         48"       —       —       70.0       90.0         54"       —       —       70.0       90.0         57"       —       —       70.0       90.0	Ш	í	-						
72"         —         —         70.0         90.0           75"         —         —         70.0         90.0           78"         —         —         70.0         90.0           48"         55.0         70.0         70.0         90.0           51"         55.0         70.0         70.0         90.0           57"         55.0         70.0         70.0         90.0           60"         55.0         70.0         70.0         90.0           63"         55.0         70.0         70.0         90.0           66"         55.0         70.0         70.0         90.0           69"         —         —         70.0         90.0           72"         —         —         70.0         90.0           48"         —         —         70.0         90.0           54"         —         —         70.0         90.0           57"         —         —         70.0         90.0	Н	;	F						
75"         —         —         —         70.0         90.0           48"         —         —         —         70.0         90.0           51"         55.0         70.0         70.0         90.0           54"         55.0         70.0         70.0         90.0           57"         55.0         70.0         70.0         90.0           60"         55.0         70.0         70.0         90.0           63"         55.0         70.0         70.0         90.0           66"         55.0         70.0         70.0         90.0           69"         —         —         —         70.0         90.0           72"         —         —         70.0         90.0           48"         —         —         70.0         90.0           54"         —         —         70.0         90.0           57"         —         —         70.0         90.0	П		F	- 55.0	70.0				
78"         —         —         70.0         90.0           48"         55.0         70.0         70.0         90.0           51"         55.0         70.0         70.0         90.0           54"         55.0         70.0         70.0         90.0           57"         55.0         70.0         70.0         90.0           60"         55.0         70.0         70.0         90.0           66"         55.0         70.0         70.0         90.0           69"         —         —         70.0         90.0           72"         —         —         70.0         90.0           48"         —         —         70.0         90.0           51"         —         —         70.0         90.0           54"         —         —         70.0         90.0           57"         —         —         70.0         90.0	П	1	F		_				
48"       55.0       70.0       70.0       90.0         51"       55.0       70.0       70.0       90.0         54"       55.0       70.0       70.0       90.0         57"       55.0       70.0       70.0       90.0         60"       55.0       70.0       70.0       90.0         63"       55.0       70.0       70.0       90.0         69"       -       -       70.0       90.0         72"       -       -       70.0       90.0         75"       -       -       70.0       90.0         48"       -       -       70.0       90.0         51"       -       -       70.0       90.0         54"       -       -       70.0       90.0         57"       -       -       70.0       90.0	Ш		<u> </u>						
51"     55.0     70.0     70.0     90.0       54"     55.0     70.0     70.0     90.0       57"     55.0     70.0     70.0     90.0       60"     55.0     70.0     70.0     90.0       63"     55.0     70.0     70.0     90.0       69"     -     -     70.0     90.0       72"     -     -     70.0     90.0       75"     -     -     70.0     90.0       48"     -     -     70.0     90.0       54"     -     -     70.0     90.0       57"     -     -     70.0     90.0	$\prod$			55.0	70.0				
54"     55.0     70.0     70.0     90.0       57"     55.0     70.0     70.0     90.0       60"     55.0     70.0     70.0     90.0       63"     55.0     70.0     70.0     90.0       66"     55.0     70.0     70.0     90.0       69"     -     -     70.0     90.0       72"     -     -     70.0     90.0       75"     -     -     70.0     90.0       48"     -     -     70.0     90.0       51"     -     -     70.0     90.0       54"     -     -     70.0     90.0       57"     -     -     70.0     90.0	Ш	1	F						
57"     55.0     70.0     70.0     90.0       60"     55.0     70.0     70.0     90.0       63"     55.0     70.0     70.0     90.0       66"     55.0     70.0     70.0     90.0       69"     -     -     70.0     90.0       72"     -     -     70.0     90.0       75"     -     -     70.0     90.0       48"     -     -     70.0     90.0       51"     -     -     70.0     90.0       54"     -     -     70.0     90.0       57"     -     -     70.0     90.0	Ш	- 1	F						
60"     55.0     70.0     70.0     90.0       63"     55.0     70.0     70.0     90.0       66"     55.0     70.0     70.0     90.0       69"     -     -     70.0     90.0       72"     -     -     70.0     90.0       75"     -     -     70.0     90.0       48"     -     -     70.0     90.0       51"     -     -     70.0     90.0       54"     -     -     70.0     90.0       57"     -     -     70.0     90.0	11	57"		55.0					
63"     55.0     70.0     70.0     90.0       66"     55.0     70.0     70.0     90.0       69"     —     —     70.0     90.0       72"     —     —     70.0     90.0       75"     —     —     70.0     90.0       48"     —     —     70.0     90.0       51"     —     —     70.0     90.0       54"     —     —     70.0     90.0       57"     —     —     70.0     90.0		60"	114"	55.0	70.0				
69"     —     —     70.0     90.0       72"     —     —     70.0     90.0       75"     —     —     70.0     90.0       48"     —     —     70.0     90.0       51"     —     —     70.0     90.0       54"     —     —     70.0     90.0       57"     —     —     70.0     90.0		63"	114	55.0	70.0	70.0			
72"     —     —     70.0     90.0       75"     —     —     70.0     90.0       48"     —     —     70.0     90.0       51"     —     —     70.0     90.0       54"     —     —     70.0     90.0       57"     —     —     70.0     90.0	Ш	66"		55.0	70.0	70.0	90.0		
75"         -         -         70.0         90.0           48"         -         -         70.0         90.0           51"         -         -         70.0         90.0           54"         -         -         70.0         90.0           57"         -         -         70.0         90.0	Ш	69"		_		70.0	90.0		
48"     -     -     70.0     90.0       51"     -     -     70.0     90.0       54"     -     -     70.0     90.0       57"     -     -     70.0     90.0				-	- 1	70.0	90.0		
51"	IL					70.0	90.0		
54" 70.0 90.0 57" 70.0 90.0		i		-		70.0	90.0		
57" - 70.0 90.0		i i	L		-	70.0	90.0		
				-		70.0	90.0		
1 60"   120"   -   -   700   000				-	-	70.0	90.0		
7.00 55.0		60"	120"			70.0	90.0		
63" - 70.0 90.0		1				70.0	90.0		
66" 70.0 90.0		1	<u> </u>	-					
69" - 70.0 90.0			-						
72" - 70.0 90.0	_	12				70.0	90.0		

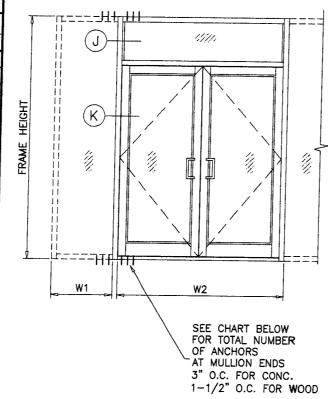

WIDTH	(w)	_	W1	+	W2
MIDIU	(")	_		2	

TOTAL I	WITH RE	INFORCING				
ANCHOR TYPE	ANCHOR DESCRIPTION	SUBSTRATE		ANCHORS		
	DESCRIPTION		HEAD	SILL	HEAD	SILL
		WOOD STRUCTURE	8	8	11	11
A	1/4" TAPCONS	THRU 1BY OR 2BY BUCKS INTO CONC.	8	8	11	11
В	1/4" TAPCONS	DIRECTLY INTO CONCRETE	4	4	6	6
С	#24 WOOD SCREWS 3" MIN. EMBED	WOOD STRUCTURE	5	5	7	7
D	1/4-20 KWIK-FLEX SELF DRILLING SCREWS	METAL STRUCTURES STL. OR ALUM 1/8" MIN. THK.	4	4	6	6

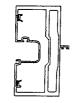


W/O REINFORCING



WITH REINFORCING


HORIZONTAL LOAD CAPACITY-PSF								
HEIGHT (H)	WIDTH	HORIZO	NTAL-A	HORIZO	NTAL-B	HORIZONTAL-C&D		
INCHES	INCHES	EXT. (+)	INT. (-)	EXT. (+)	INT. (-)	EXT. (+)	INT. (-)	
51"		70.0	90.0	70.0	90.0	70.0	90.0	
54"	72"	70.0	90.0	70.0	90.0	70.0	90.0	
57"	, 2	70.0	90.0	70.0	90.0	70.0	90.0	
60"		70.0	90.0	70.0	90.0	70.0	90.0	
51"		70.0	90.0	70.0	90.0	70.0	90.0	
54"	78"	70.0	90.0	70.0	90.0	70.0	90.0	
57"	78	70.0	90.0	70.0	88.1	70.0	90.0	
60"		70.0	86.3	70.0	83.7	70.0	90.0	
51"	84"	70.0	90.0	70.0	90.0	70.0	90.0	
54"		70.0	89.0	70.0	86.3	70.0	90.0	
57"		70.0	84.4	70.0	81.8	70.0	90.0	
60"		70.0	80.1	70.0	77.7	70.0	90.0	
51"		70.0	88.0	70.0	85.3	70.0	90.0	
54"	90"	70.0	83.1	70.0	80.6	70.0	90.0	
57"		70.0	78.7	70.0	76.3	70.0	90.0	
60"		70.0	74.8	70.0	72.5	70.0	90.0	
51"		70.0	82.5	70.0	80.0	70.0	90.0	
54"	96"	70.0	77.9	70.0	75.5	70.0	90.0	
57"		70.0	73.8	70.0	71.6	70.0	90.0	
60"		70.0	70.1	68.0	68.0	70.0	90.0	

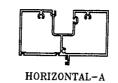




HORIZONTAL-B



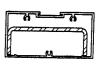

HORIZONTAL-D

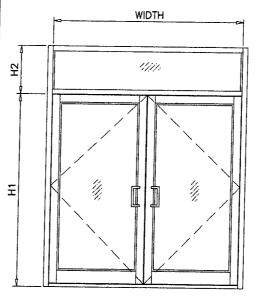

Approved as complying with the Florida Building Code Date 05/20/04
NOA#04-0222-02
Miami Dade Product Control
Division
By Level Low

 $HEIGHT (H) = \frac{H1 + H2}{2}$ 

PRODUCT REVISED as complying with the Florida Building Code
Acceptance No 09-0518.09
Expiration Date TUNE 10, 2010

By Shag Lhande Miami Dade Product Control Division

gr: DR. HUMAYOUN FAROOQ STRUCTURES FLA. PE # 16557 C-A.N. 3538	
#	Ŀ
MAR 2 9 2004	

drawing no. W03-94

sheet 4 of 11

MENTS

WENTS

WENTS

WITH AP AMERICA INC.


3.32 FIRETOWER ROAD


DUBLIN, GEORGIA 31021


TEL(478) 277–1955 FAX(478) 277–1978


C


AL-FAROOQ CORPORATION
ENGINEERS, PLANNERS & PRODUCT DESIGN
1235 SW 87 AVE
MIAMI, FLORIDA 33174
TEL. (305) 264-8100 FAX. (305) 262-6978

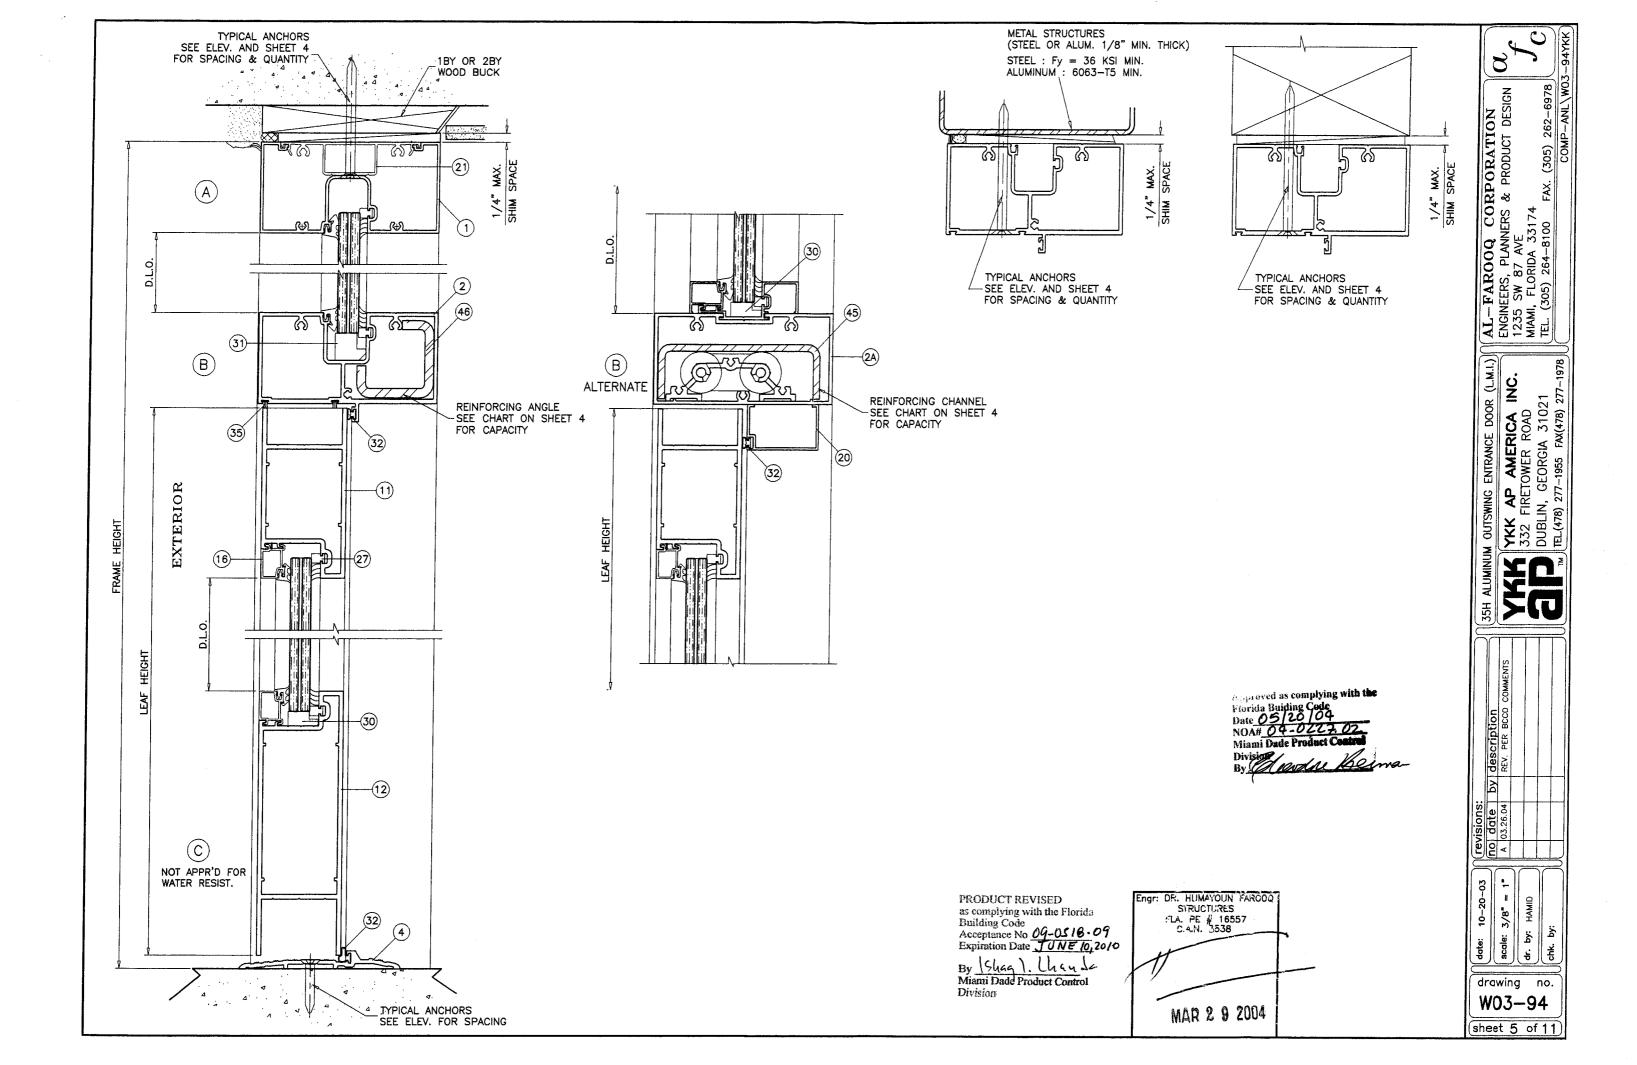


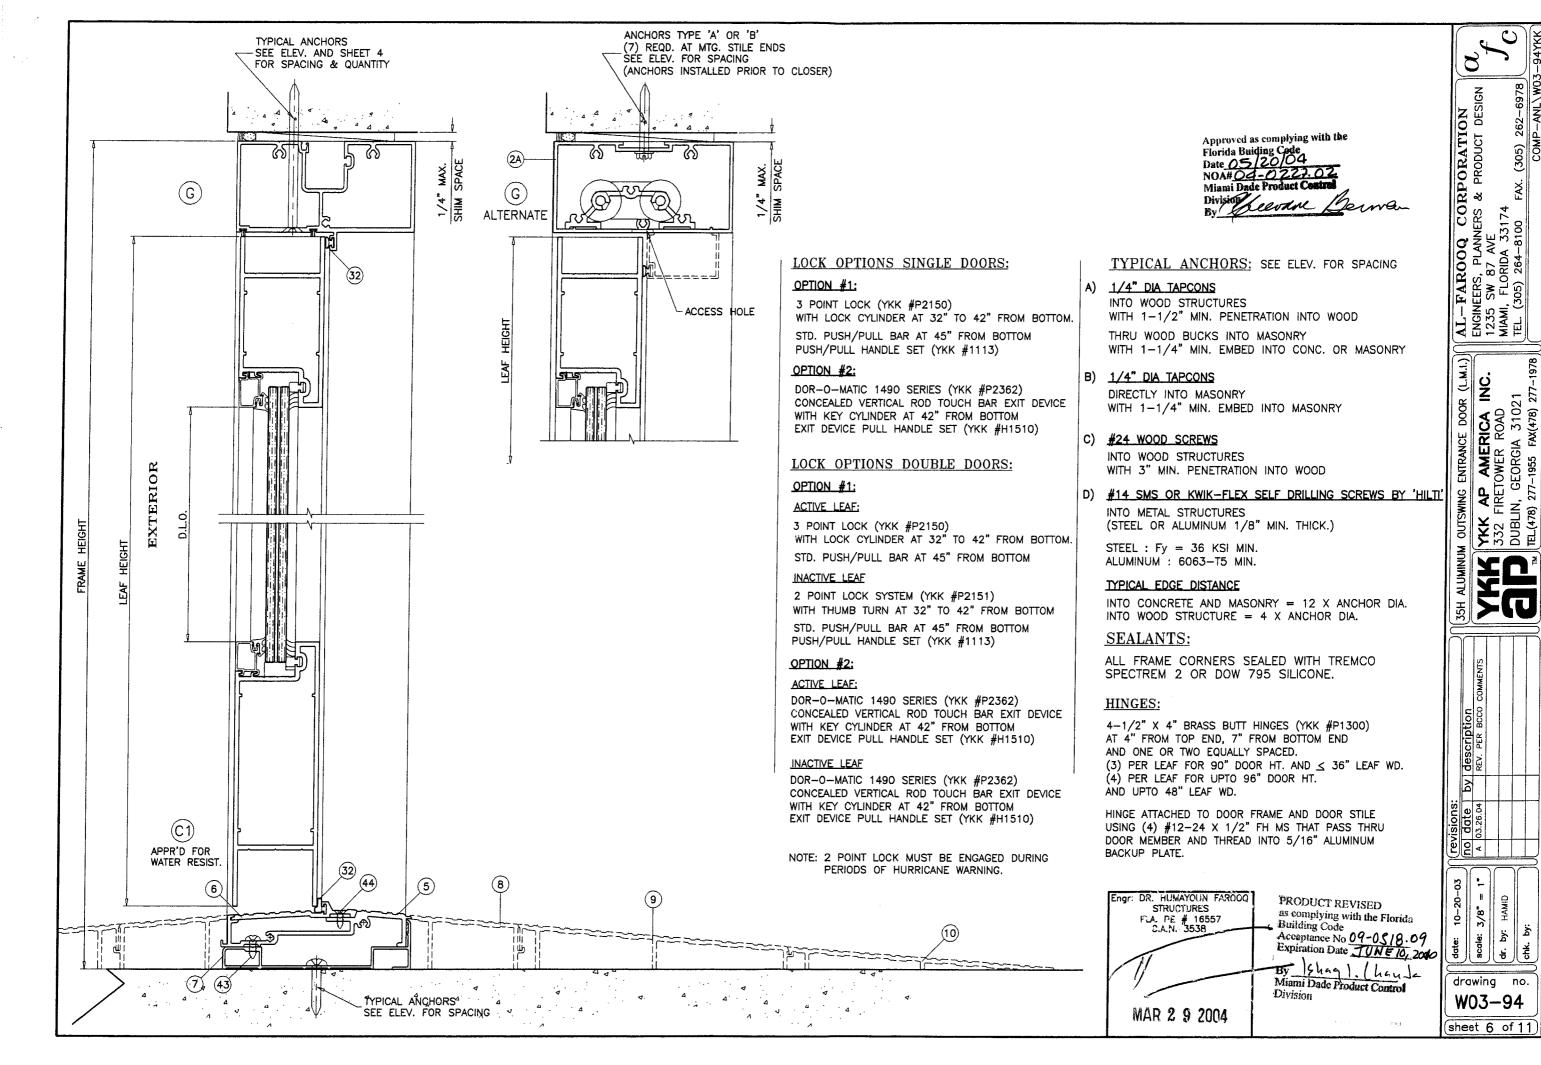


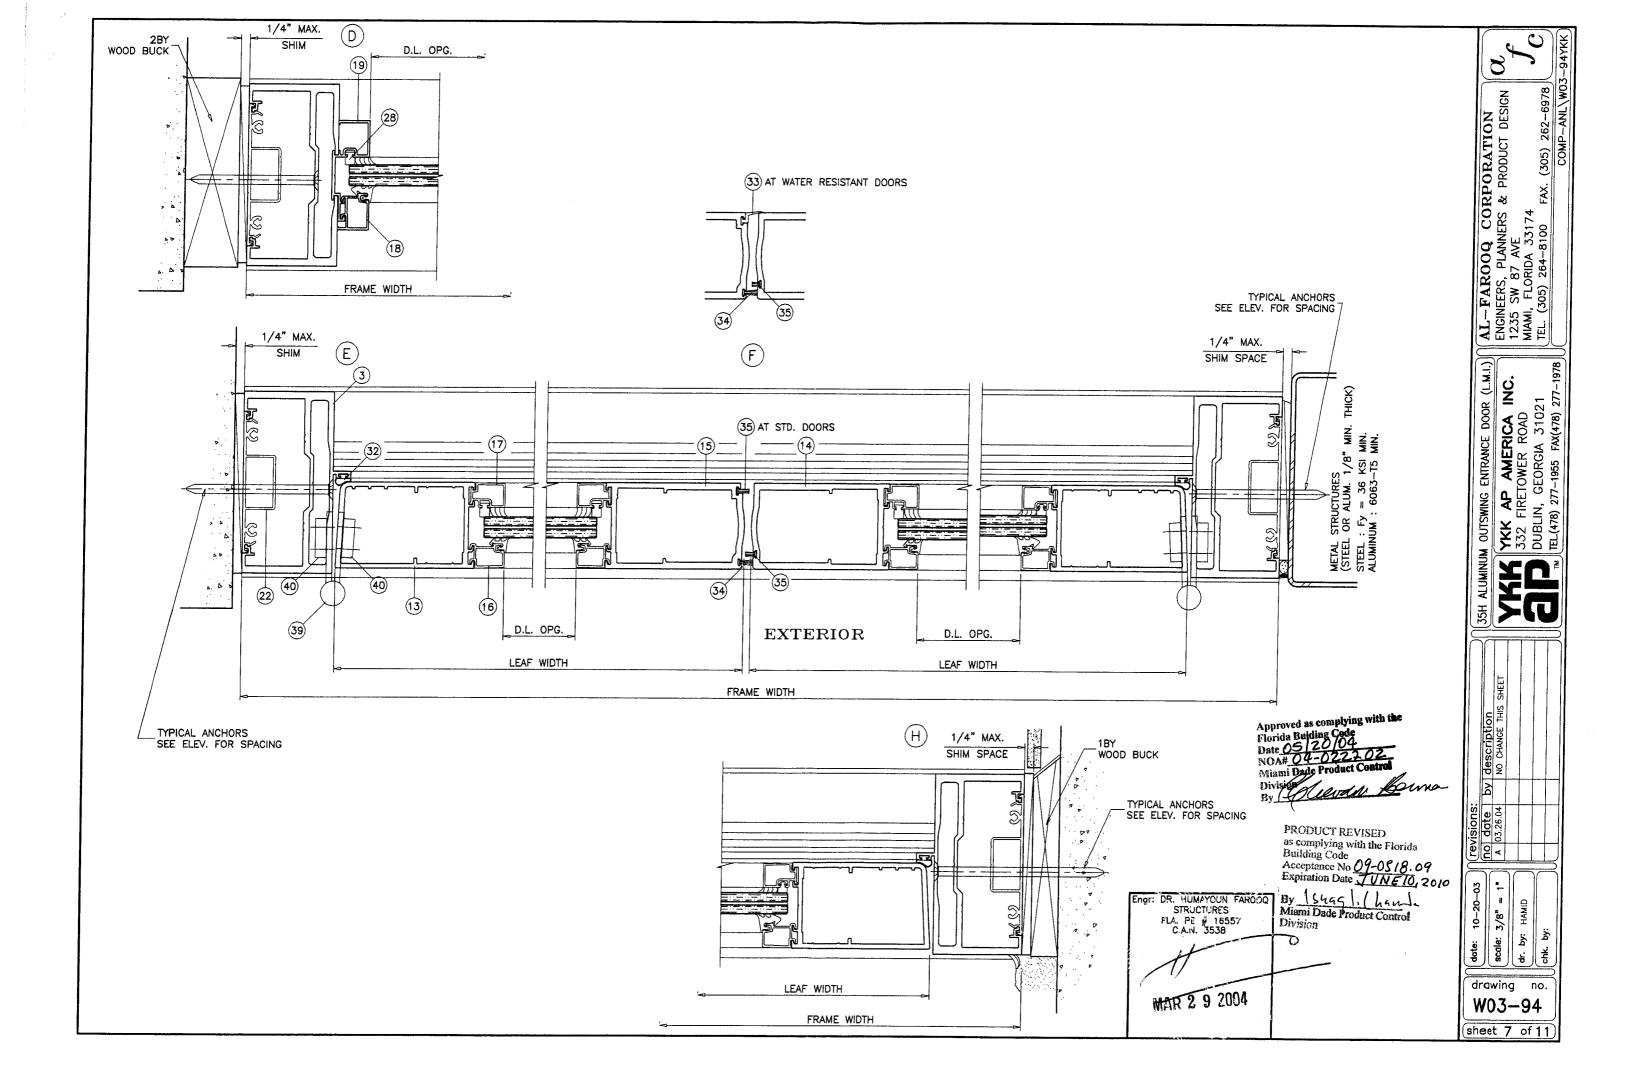


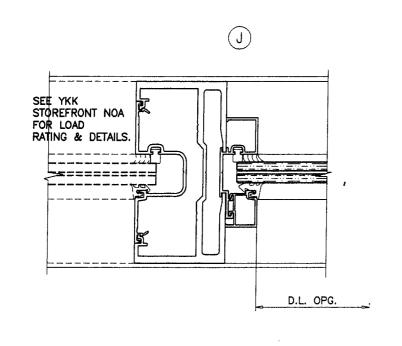

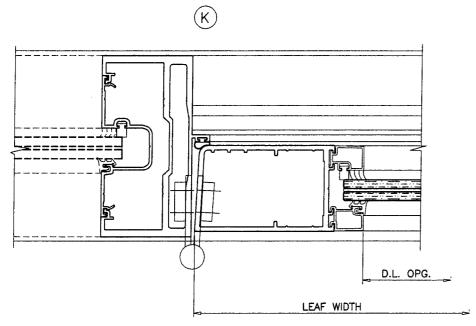

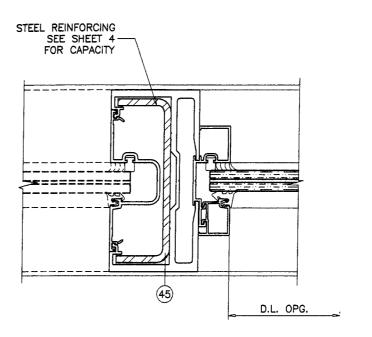

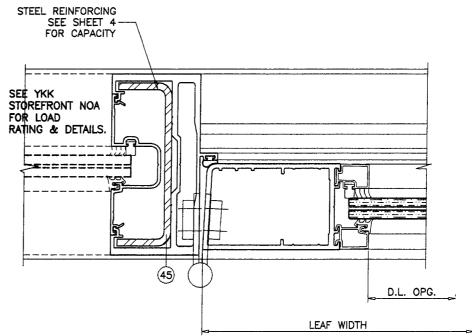

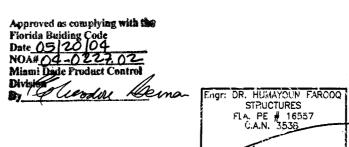

MAR 2 9 2004

PRODUCT REVISED
as complying with the Florida
Building Code
Acceptance No 09-05 18.09
Expiration Date JUNE 10, 2010 By Ghay Chan Le Miami Dade Product Control Division

date: 10–20–0
scale: 3/8" =

dr. by: HAMID

chk. by: drawing no.

AL-FAROOQ CORPORATION
ENGINEERS, PLANNERS & PRODUCT DESIGN
1235 SW 87 AVE
MIAMI, FLORIDA 33174
TEL. (305) 264-8100 FAX. (305) 262-6978


| 35H ALUMINUM OUTSWING ENTRANCE DOOR (L.M.I.) | YKK AP AMERICA INC. | 332 FIRETOWER ROAD | DUBLIN, GEORGIA 31021 | IEL.(478) 277-1955 FAX(478) 277-1978

W03-94

sheet 8 of 11

revisions:

no date by description
A 03.26.04 NO CHANGE THIS S

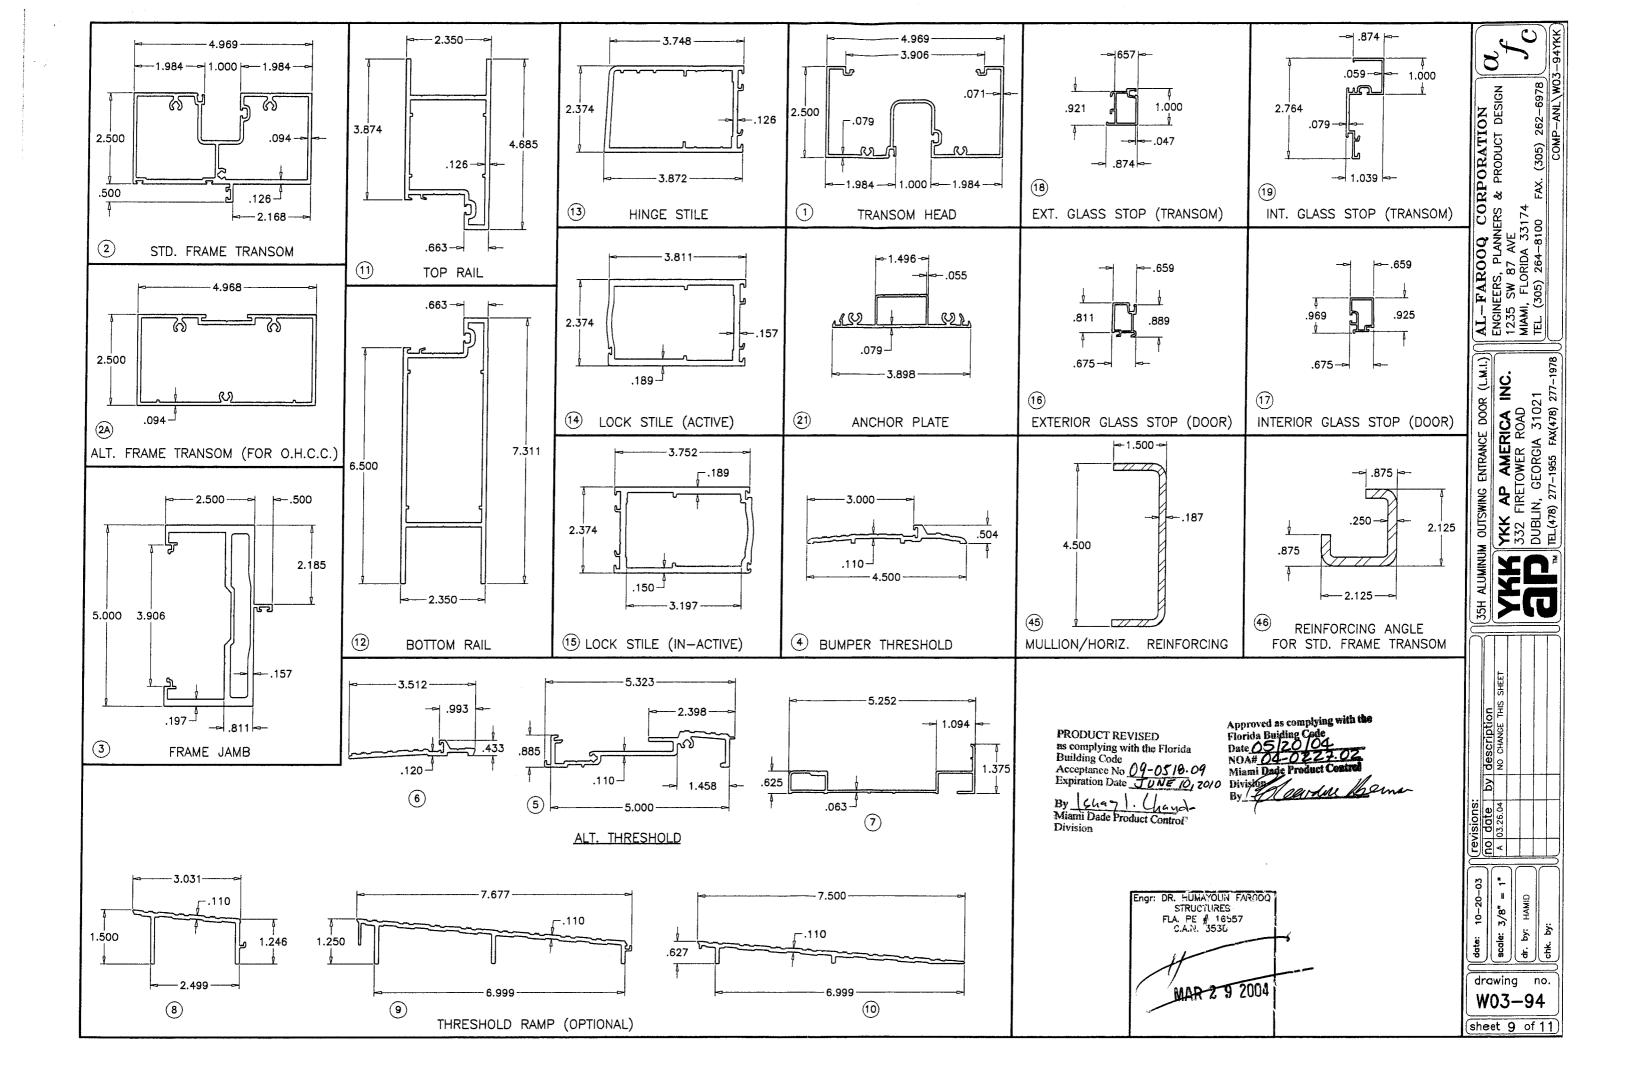

ITEM #	PART #	REQD.	DESCRIPTION	MATERIAL	MANF./SUPPLIER/REMARKS
1	E9-0601	1	FRAME HEAD	6063-T5	YKK AP AMERICA
2	E9-0501	AS REQD.	FRAME TRANSOM	6063-T5	YKK AP AMERICA
2A	E9-0514	AS REQD.	ALT. FRAME TRANSOM	6063-T5	YKK AP AMERICA
3	E9-0504	2	FRAME JAMB	6063-T5	YKK AP AMERICA
4	E9-0487	1	BUMPER THRESHOLD	6063-T5	YKK AP AMERICA
5	E9-0502	1	ALT. THRESHOLD	6063-T5	YKK AP AMERICA
6	E9-0503	1	THRESHOLD ATTACHMENT	6063-T5	YKK AP AMERICA
7	E9-0611	1	SILL FLASHING	6063-T5	YKK AP AMERICA
8	-	AS REQD.	RAMP PIECE 1	6063-T5	YKK AP AMERICA
9	-	AS REQD.	RAMP PIECE 2	6063-T5	YKK AP AMERICA
10	_	AS REQD.	RAMP PIECE 3	6063-T5	YKK AP AMERICA
11	E9-0220	1/ LEAF	TOP RAIL	6063-T5	YKK AP AMERICA
12	E9-0221	1/ LEAF	BOTTOM RAIL	6063-T5	YKK AP AMERICA
13	E9-0222	1 OR 2/ LEAF	HINGE STILE	6063-T5	YKK AP AMERICA
14	E9-0223	1	LOCK STILE (ACTIVE) @ DOUBLE DOORS	6063-T5	YKK AP AMERICA
15	E9-0230	1	LOCK STILE (IN-ACTIVE) @ DOUBLE DOORS	6063-T5	YKK AP AMERICA
16	E9-0225	4/ LEAF	EXTERIOR GLASS STOP (DOOR)	6063-T5	YKK AP AMERICA
17	E9-0226	2/ LEAF	INTERIOR GLASS STOP (DOOR)	6063-T5	YKK AP AMERICA
18	E9-0506	AS REQD.	EXTERIOR GLASS STOP (TRANSOM JAMB)	6063-T5	YKK AP AMERICA
19	E9-0505	AS REQD.	INTERIOR GLASS STOP (TRANSOM JAMB)	6063-T5	YKK AP AMERICA
20	E9-0215	1/ DOOR	DOOR STOP	6063-T5	YKK AP AMERICA
21	E1-1071	AS REQD.	ANCHOR PLATE (HEAD), 7-1/2" LONG	6063-T5	YKK AP AMERICA
22	E1-1068A	AS REQD.	ANCHOR PLATE (JAMB), 2-1/2" LONG	6063-T5	YKK AP AMERICA
23	E1-0351	1/ LEAF	TOP RAIL JOINT CLIP, 2.453" LONG	6063-T5	YKK AP AMERICA
23A	E1-0352	1/ LEAF	BOTTOM RAIL JOINT CLIP, 4.516" LONG	6063-T5	YKK AP AMERICA
24	E2-0081	AS REQD.	EXTERIOR GLAZING GASKET	EPDM	_
25	E2-0082	AS REQD.	EXTERIOR GLAZING GASKET	EPDM	_
26	E2-0083	AS REQD.	EXTERIOR GLAZING GASKET	EPDM	_
27	E2-0085	AS REQD.	INTERIOR SILICONE SPACER (DOOR)	EPDM	<del></del>
28	E2-0084	AS REQD.	INTERIOR SILICONE SPACER (TRANSOM)	EPDM	_
29	995	AS REQD.	GLAZING COMPOUND	SILICONE	DOW CORNING
30	E2-0086	3/ LEAF	SETTING BLOCK (DOOR)	EPDM	_
31	E2-0080	AS REQD.	SETTING BLOCK (TRANSOM)	EPDM	<del>-</del>
32	E2-0051	AS REQD.	BULB W'STRIPPING	PVC	_
33	E2-0093	AS REQD.	ASTRAGAL GASKET	EPDM	FOR WATER RESISTANT DOORS ONLY
34	E2-0087	AS REQD.	PILE W'STRIPPING	_	-
35	E2-0062	AS REQD.	PILE W'STRIPPING	-	-
36	_	-	_	- 1	_
37	E1-0311	2/ LEAF	BACK PLATE FOR SHEAR BLOCK TOP	STEEL	_
38	E1-0312	2/ LEAF	BACK PLATE FOR SHEAR BLOCK BOTTOM	STEEL	_
39	H-2301	3 OR 4/ LEAF	BUTT HINGE KIT INCLUDING SCREWS	BRASS	SEE SHEET 6 FOR QUANTITY
40	E1-0357	3 OR 4/ LEAF	HINGE BACKER PLATE	6063-T5	SEE SHEET 6 FOR QUANTITY
41	_	_	-	- 1	-
42	PC-1216	AS REQD.	FRAME ASSEMBLY SCREWS	STEEL	#12 X 1" PH SMS
43	PC-1408	2	THRESHOLD SCREWS	STEEL	#14 X 1/2" PH SMS
44	FC 1008	AS REQD.	THRESHOLD SCREWS	STEEL	#10 X 1/2" FH SMS
45	E1-1062	AS REQD.	REINFORCING CHANNEL	STEEL	1-1/2" X 4-1/2" X 3/16"
46	E1	AS REQD.	REINFORCING ANGLE	STEEL	
47	E1-1066	2	THRESHOLD CLIP	STEEL	3-1/8" X 2" X 12 GA., 1-1/4" LONG

Approved as complying with the Florida Building Code
Date 05 | 20 | 04 |
NOA# 04 - 0222.02
Miami Dade Product Control
Division PRODUCT REVISED
as complying with the Florida
Building Code
Acceptance No 09-0518.09
Expiration Date
TUNE 10, 20/0By 2 

> Engr: GR. HUMAYOUN FAROOQ STRUCTURES FLA. PE # 16557 C.A.N. 3538 MAR 2 9 2004

AL-FAROOQ CORPORATION
ENGINEERS, PLANNERS & PRODUCT DESIGN
1235 SW 87 AVE
MIAMI, FLORIDA 33174
TEL. (305) 264-8100 FAX. (305) 262-6978 YKK AP AMERICA INC.
332 FIRETOWER ROAD
DUBLIN, GEORGIA 31021
TEL(478) 277-1955 FAX(478) 277-1978 revisions:
no date by description
a 03.26.04 NO CHANGE THIS SHEET

| date: 10-20-03 | scale: 3/8" = 1" | dr. by: HAMID | chk. by:

drawing no. W03-94

sheet 10 of 11

